


Area = 176.528








PERSPECTIVE

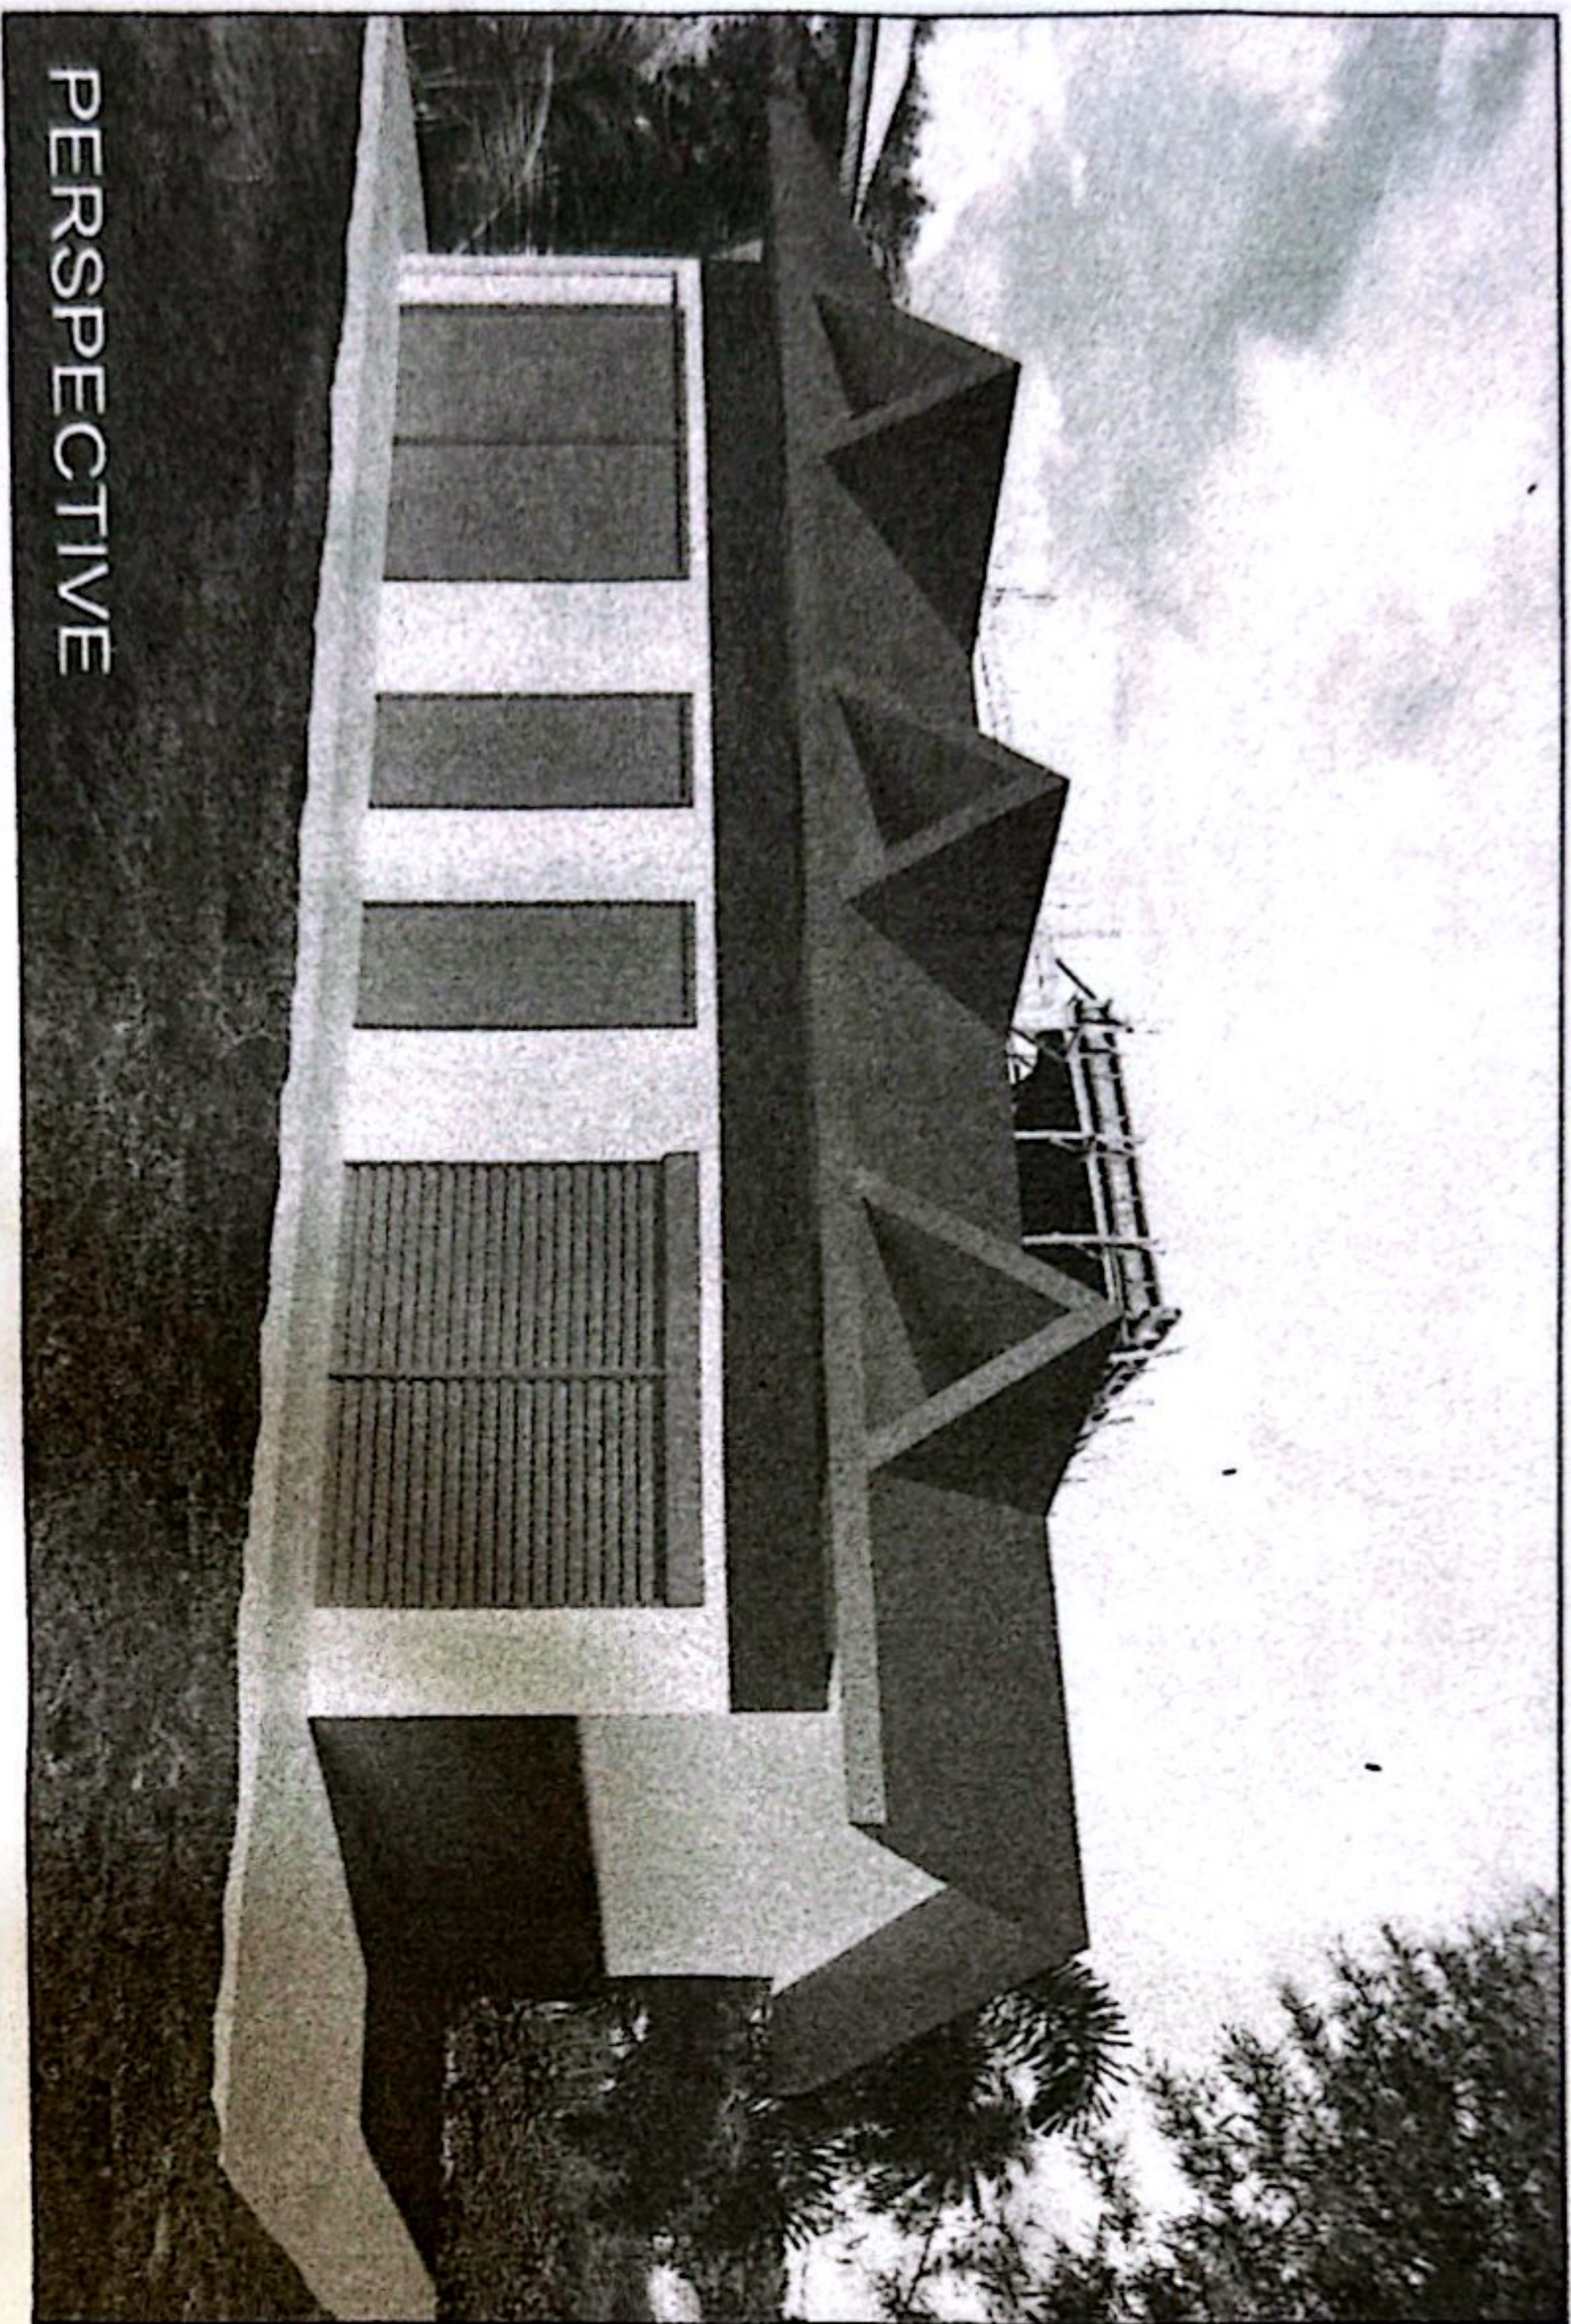


LOCATION MAP

Building Title	Prepared by	Checked by	Approved by	Sheet Content	
CONSTRUCTION OF ONE (1) STOREY BUILDING (AS BUILT)	 ROBYN M. SAGILADJA Draftsman	 RONNIE B. KANDON Civil Engineer	 MEDBAR A. VELAYO Building Owner	PERSPECTIVE LOCATION MAP	01 12
Datu Helun St. Poblacion, Bongao, Tawi - Tawi					

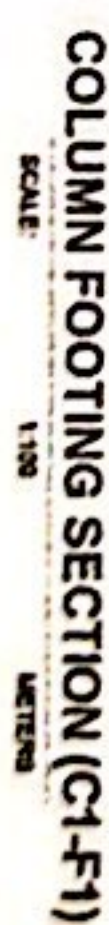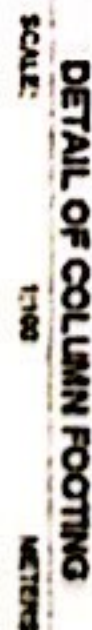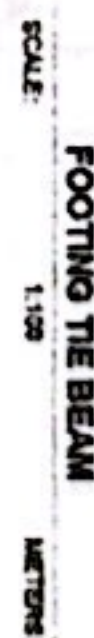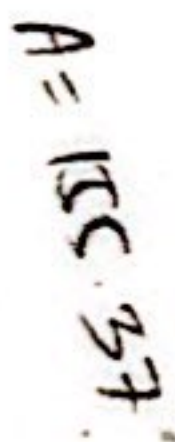


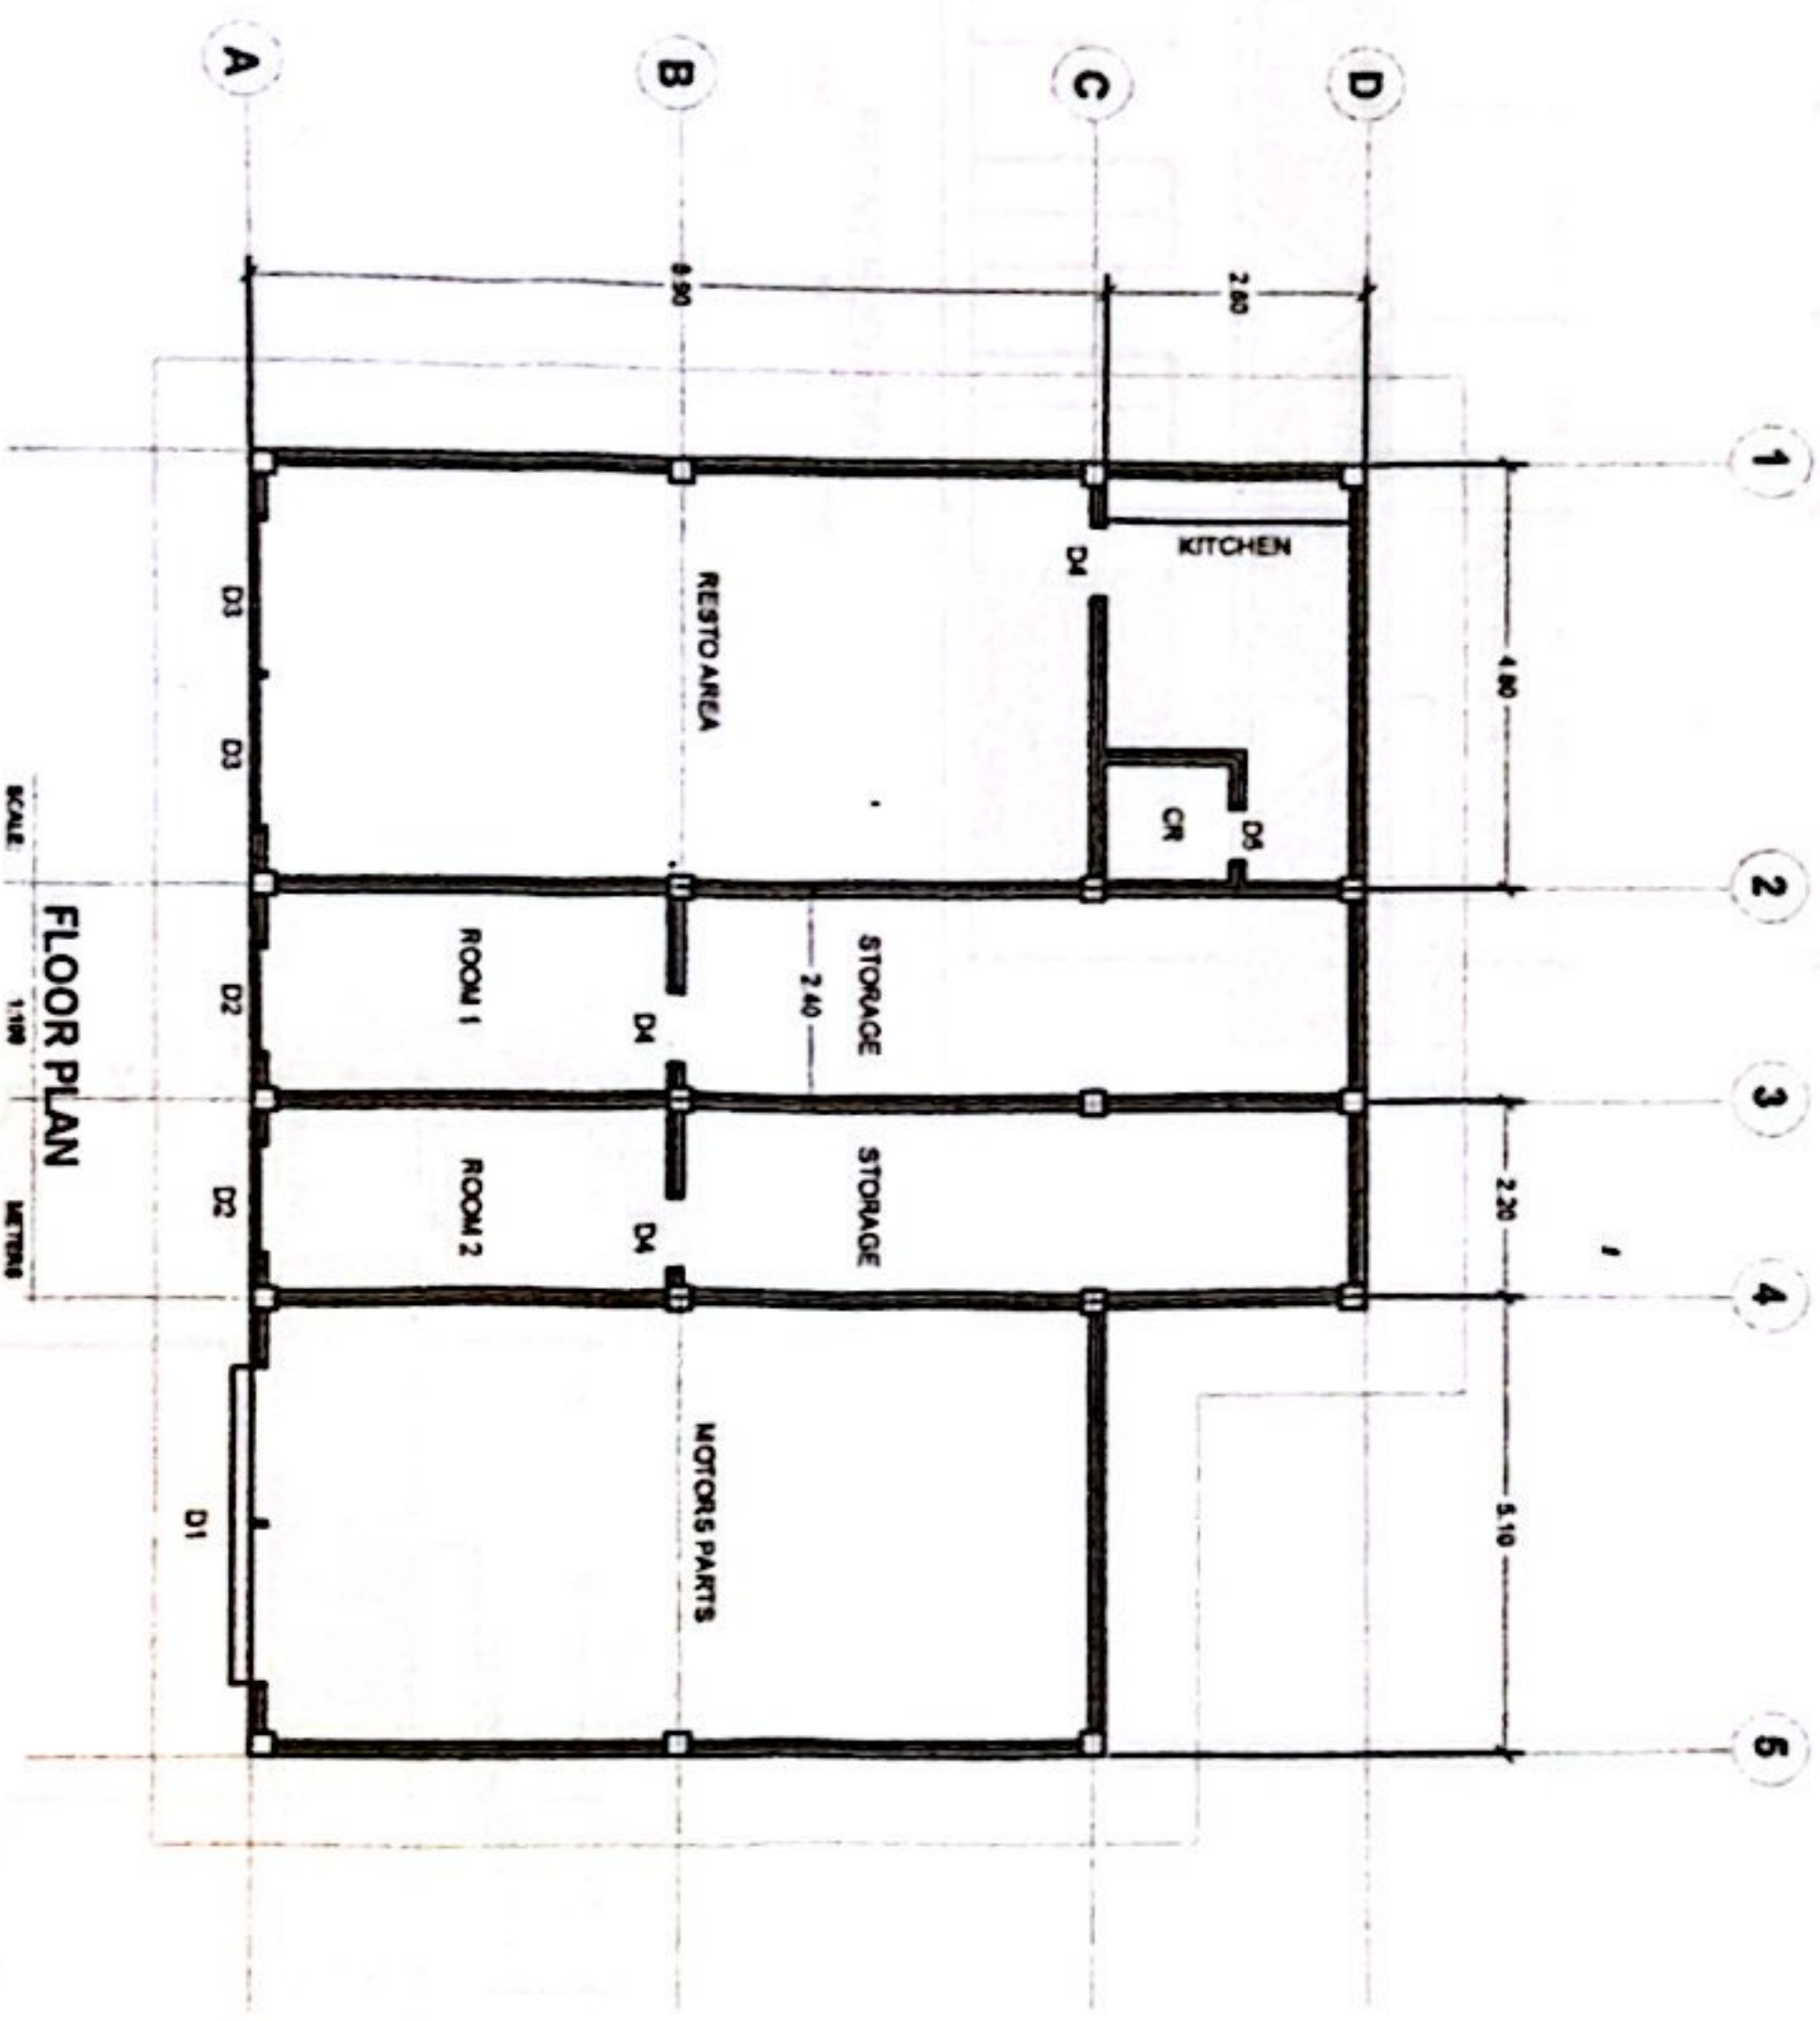

CONSTRUCTION OF ONE (1) STOREY BUILDING (AS BUILT)		Prepared by	Checked by	Approved by	Sheet Content	03 12
Mun St. Poblacion, Bongao, Tawi - Tawi		ROBINY M. SAHILKIDJA Draftsman	RONNIE G. NAMDON Civil Engineer	MEDZBAR A. KARITI Home Owner	FLOOR PLAN	

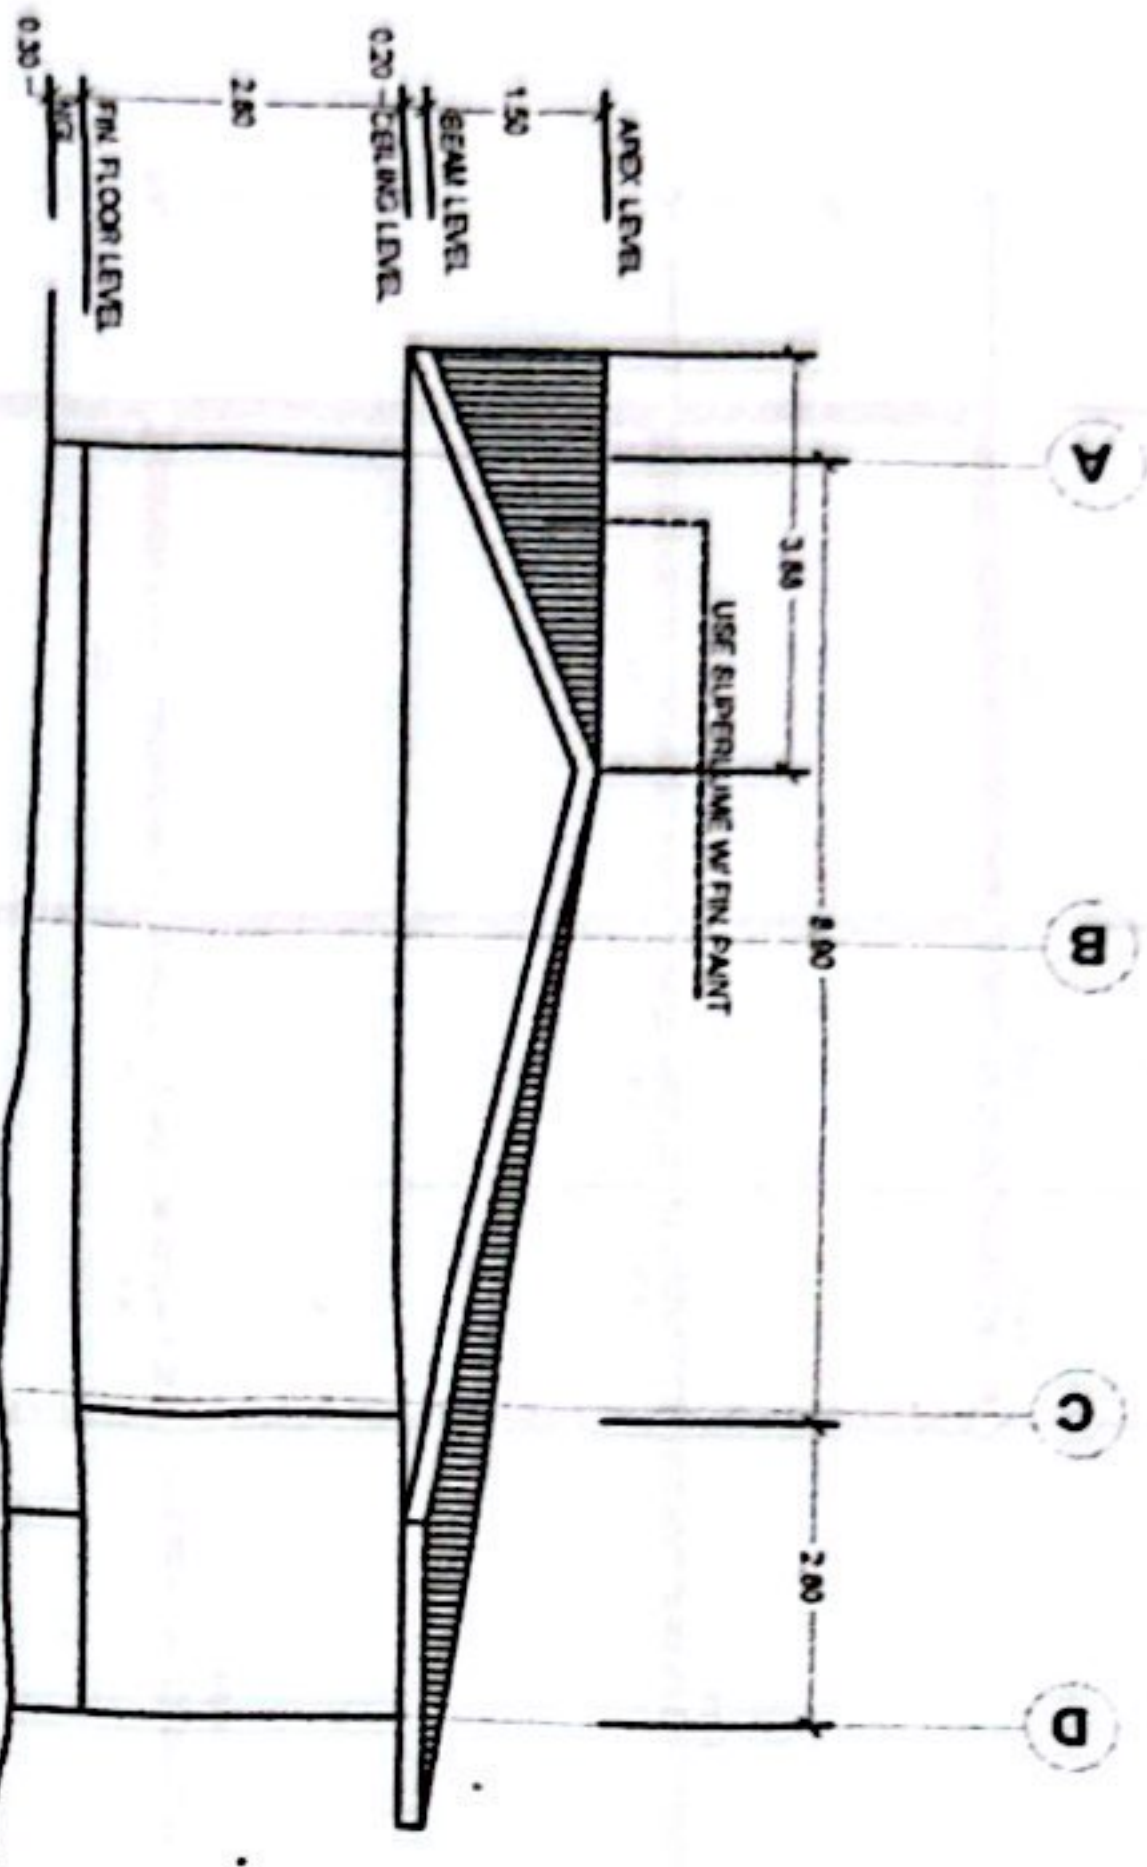

RIGHT ELEVATION
SCALE: 1:100 METERS

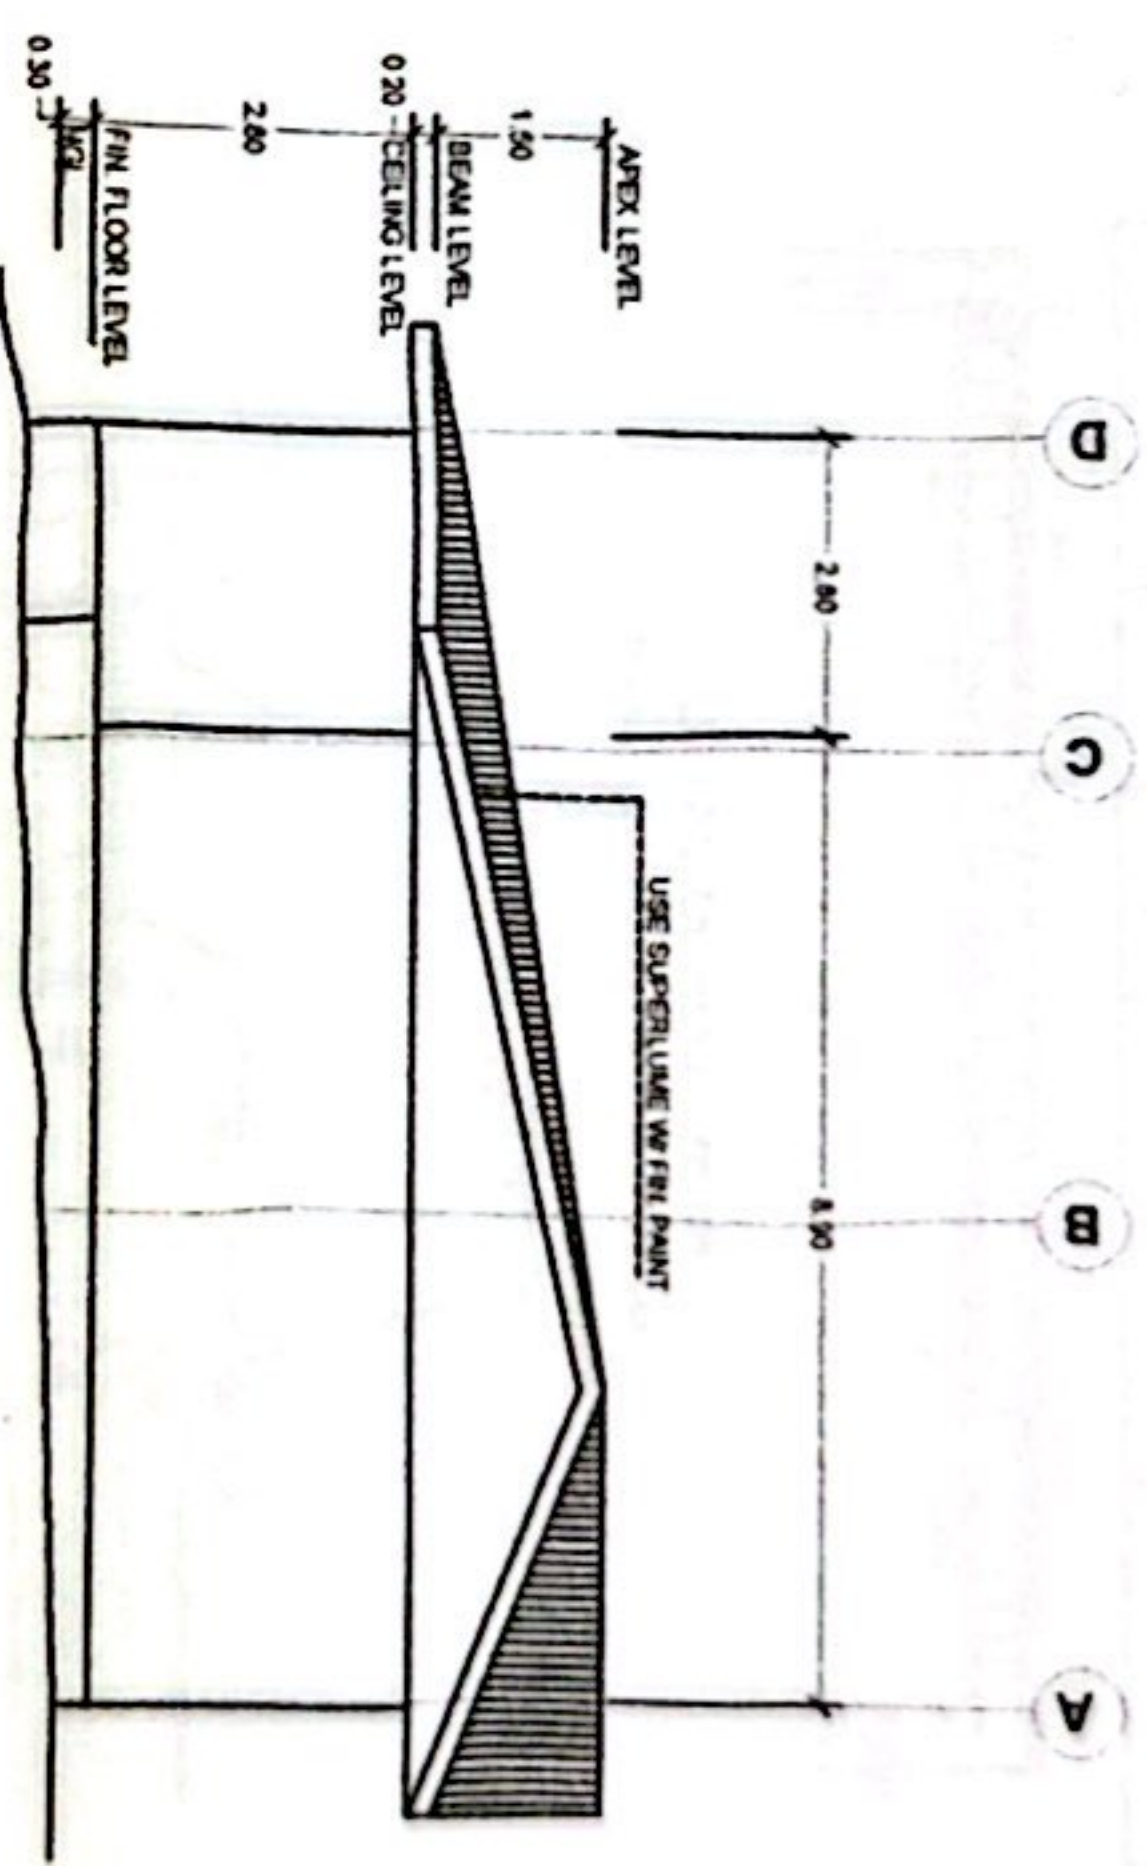

LEFT ELEVATION
SCALE: 1:100 METERS

CONSTRUCTION OF ONE (1) STOREY BUILDING (AS BUILT)

Prepared by:

Checked by:

Approved by:

Sheet Content


San St. Poblacion, Bongao, Tawi - Tawi

[Signature]
ROBIN M. SAHILABDA
Draftsman

[Signature]
RONNIE G. JORDON
Civil Engineer

[Signature]
MEDZBARA A. KANAY
Home Owner



RIGHT ELEVATION
LEFT ELEVATION

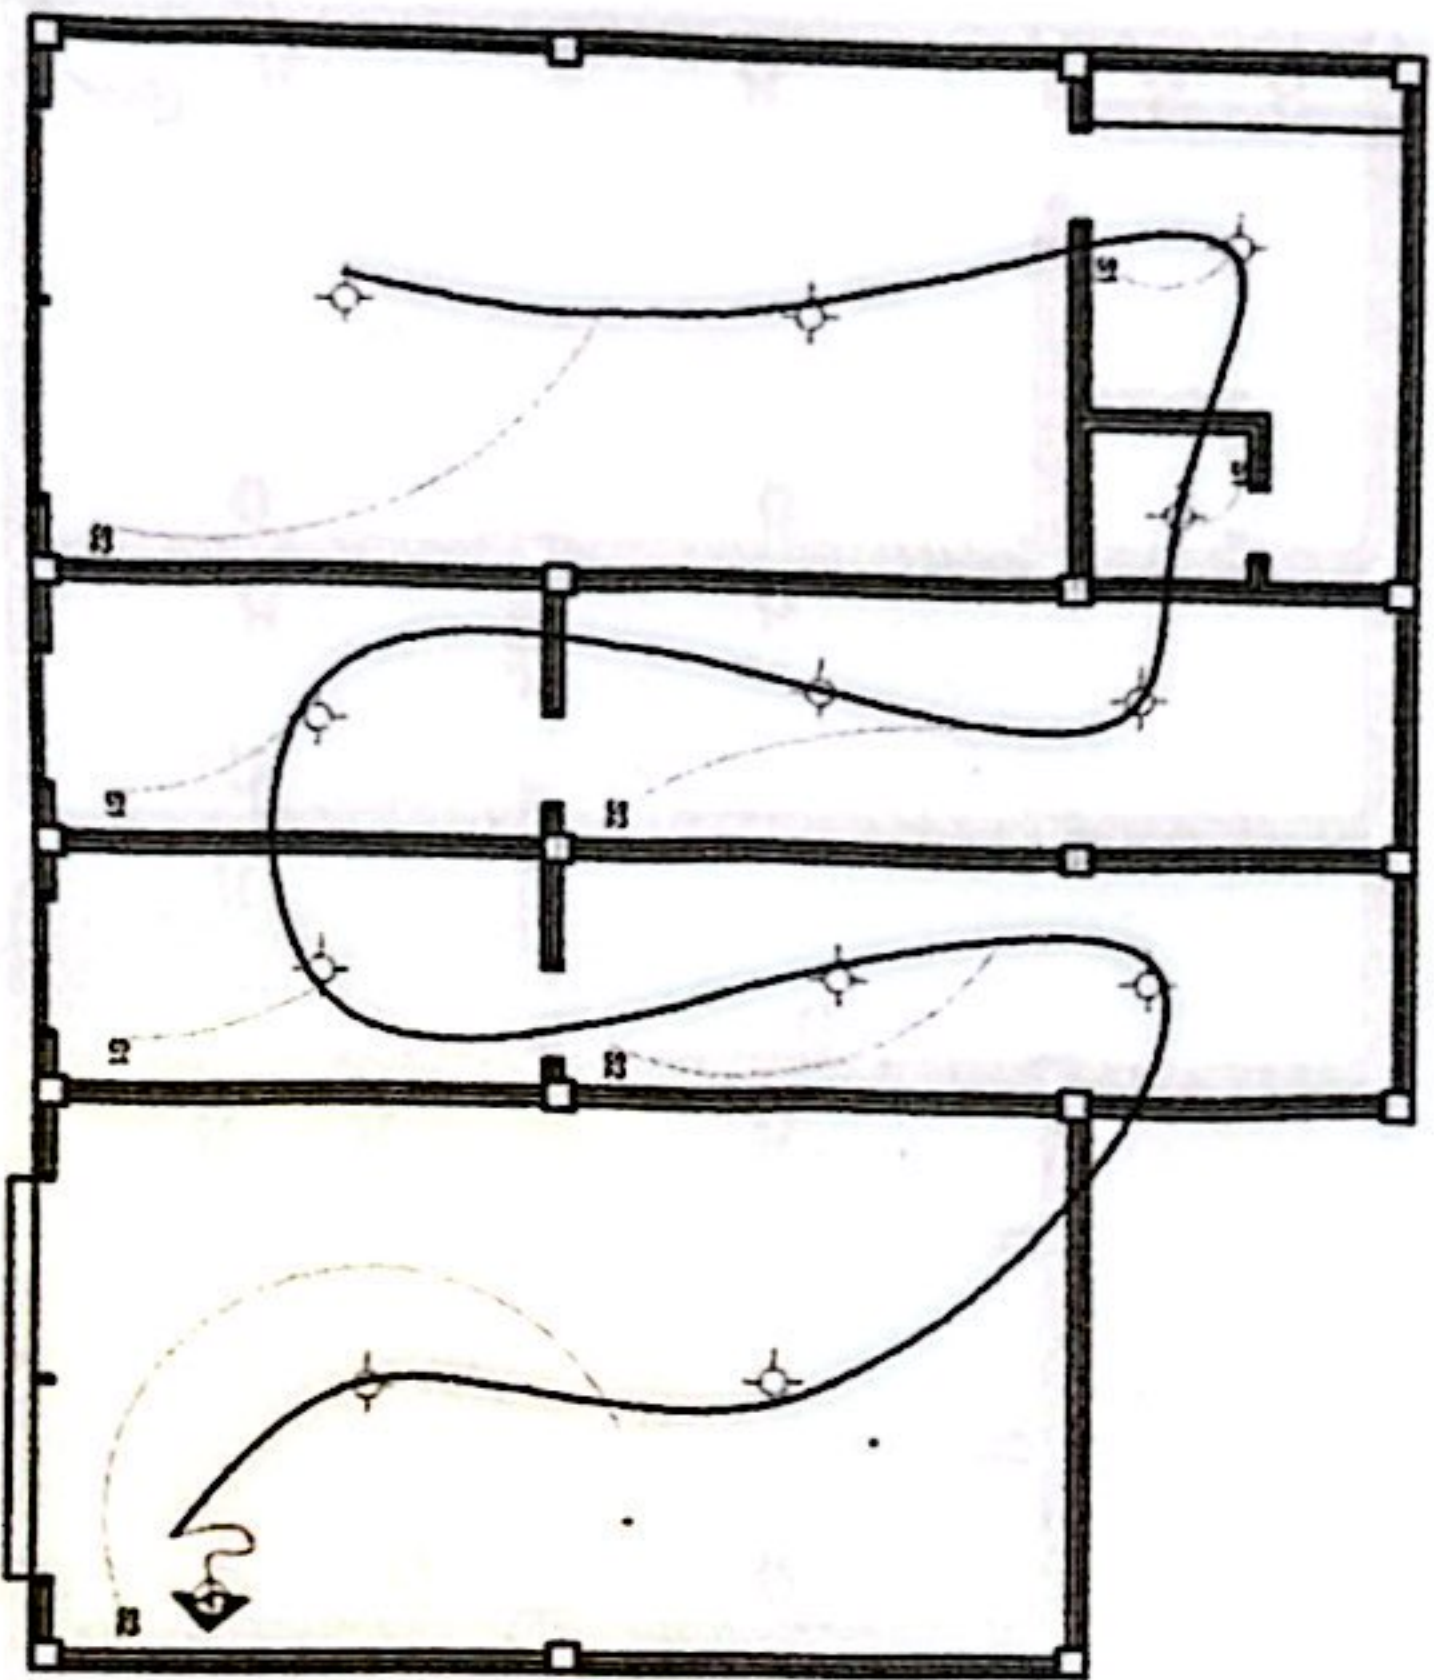

LIGHTING LAYOUT PLAN
SCALE 1:100 METERS

LEGEND

- CIRCUIT LINE ABOVE CEILING
- SWITCH LINE
- 18. W/PALELIGHT
- DOUBLE POLE SWITCH
- DOUBLE POLE SWITCH
- CIRCUIT RUN

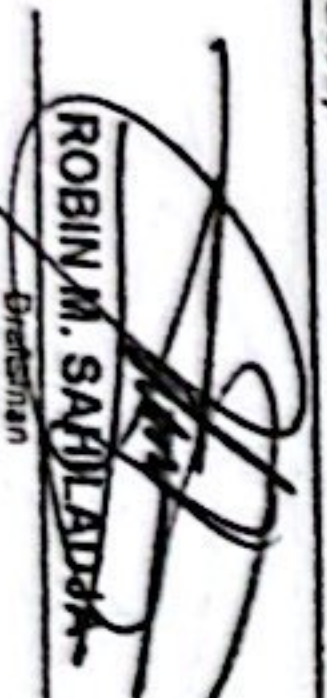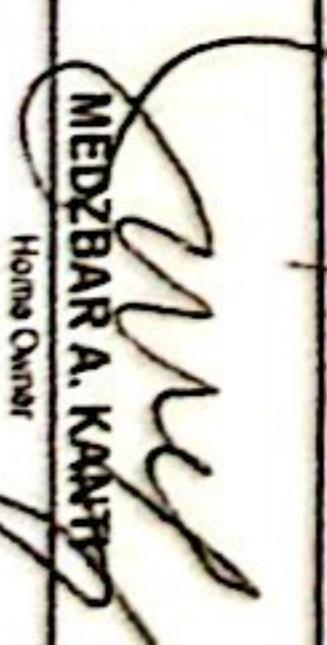CONSTRUCTION OF ONE (1) STOREY BUILDING (AS BUILT) 1/ Halun St. Poblacion, Bongao, Tawi - Tawi		Prepared by  ROBIN M. SAHILADOK Draftsman	Checked by  RONNIE G. KANDON Civil Engineer	Approved by  MEDZBAR A. KANTI Home Owner	Sheet Content LIGHTING LAYOUT PLAN	09 12
--	--	---	--	---	--	-----------------------------